


AS CONSTRUCTED DETAIL	
NAME OF ESTATE	ASTON GROVE, STAGE 1A
LOCATION	26 DARIEN STRET, BRIDGEMAN DOWNS
COUNCIL FILE	A003963559
B.C.C DELEGATES APPROVAL DATE	


**PLEASE NOTE:**

Services locations and dimensions are indicative only and may be subject to change.

These plans do not detail the exact location of services. Mirvac does not provide any warranty as to the accuracy or completeness of the information and some constructed services may not be shown. Therefore it is vital that all services are located on site by a suitably qualified person.


Mirvac will not be responsible for any loss, damage or costs incurred as a result of any errors or omissions in relation to the material in this document or for any possible actions ensuing from information contained in the document.

CERTIFICATION OF AS-CONSTRUCTED WORKS BY CIVIL CONTRACTOR	
AS THE PRINCIPAL CONTRACTOR FOR THE ABOVE CIVIL WORKS, PENSAR CONSTRUCTIONS GROUP DO CERTIFY THAT ALL CIVIL WORKS FOR THE DEVELOPMENT AT 26 DARIEN STREET, BRIDGEMAN DOWNS HAVE BEEN CONSTRUCTED UNDER THE SUPERVISION OF A PENSAR CONSTRUCTIONS GROUP REPRESENTATIVE IN ACCORDANCE WITH THE RELEVANT AUTHORITY STANDARDS, THE APPROVED CIVIL ENGINEERING PLANS AND SPECIFICATION, AND ANY ASSOCIATED APPROVED PLAN AMENDMENTS. WE CONFIRM THAT THE AS CONSTRUCTED DATA AND TESTING CERTIFICATES PROVIDED TO INTELARA INTEGRATED SOLUTIONS REPRESENT A TRUE AND ACCURATE REFLECTION OF THE WORKS COMPLETED ON SITE.	
SIGNATURE:	
NAME:	NICHOLAS SOMERVILLE
DULY AUTHORISED ON BEHALF OF:	PENSAR CONSTRUCTIONS GROUP
DATE:	25/11/15

CERTIFICATION OF AS-CONSTRUCTED WORKS BY SURVEYOR	
QUEENSLAND SURVEYING SOLUTIONS PTY LTD DO CERTIFY THAT THE AS CONSTRUCTED DATA AND PLANS PROVIDED TO PENSAR CONSTRUCTIONS GROUP (AS THE PRINCIPAL CIVIL CONTRACTOR) FOR THE DEVELOPMENT AT 26 DARIEN STREET, BRIDGEMAN DOWNS IS A TRUE AND ACCURATE REFLECTION OF THE WORKS COMPLETED ON SITE. WE CONFIRM THAT ALL DATA AND PLANS HAVE BEEN PRESENTED USING THE CORRECT DATUM AND ORIENTATION APPROPRIATE TO THE SITE IN A FORMAT AS REQUIRED BY THE RELEVANT LOCAL AUTHORITY STANDARDS.	
SIGNATURE:	
NAME:	JOHN DONALD O'BRIEN
DULY AUTHORISED ON BEHALF OF:	QUEENSLAND SURVEYING SOLUTIONS PTY LTD
DATE:	24/11/15

AHD DATUM			
BRISBANE CITY COUNCIL			
AS CONSTRUCTED CONTOUR SUBURB : BRIDGEMAN DOWNS FACET NO.			
SURVEY	QUEENSLAND SURVEYING SOLUTIONS PTY LTD	SCALE 1:500 (A3)	NO. 3 of 4 SHEET
CHECKED		DRAWING NO.	QSS519 - 000 - A



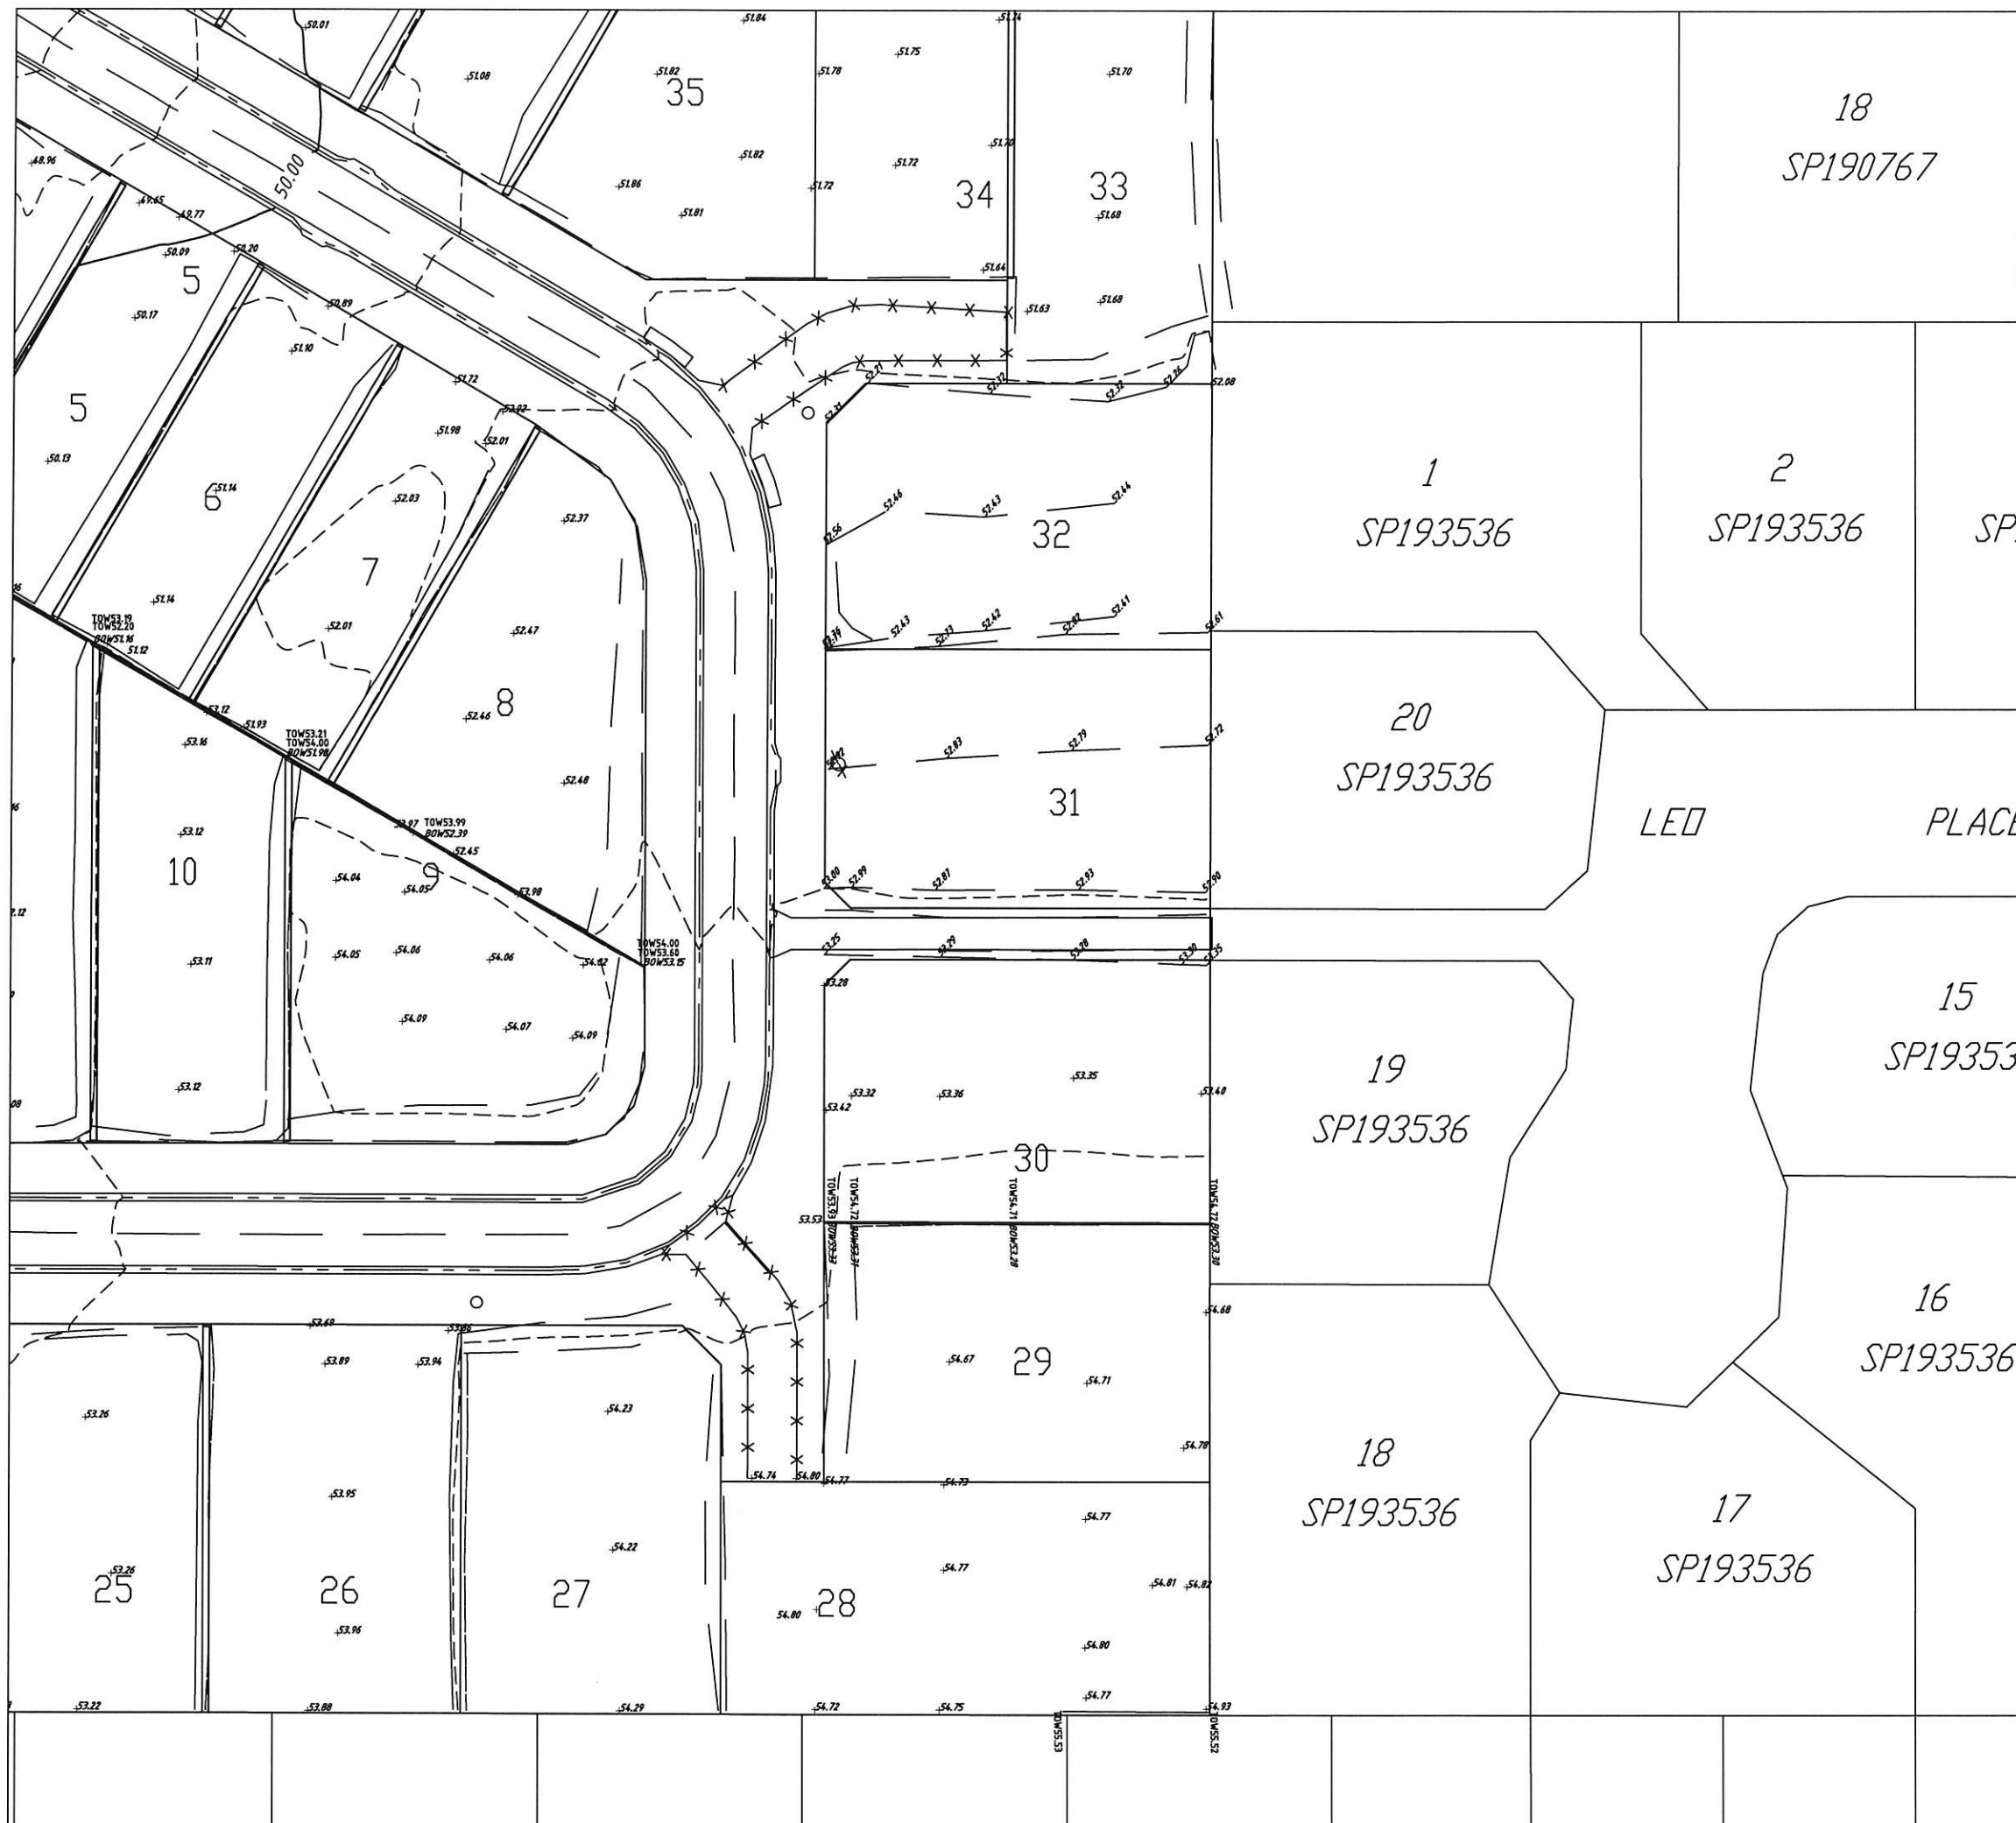


AS CONSTRUCTED DETAIL	
NAME OF ESTATE	ASTON GROVE, STAGE 1A
LOCATION	26 DARLEN STRET, BRIDGEMAN DOWNS
COUNCIL FILE	A003963559
B.C.C DELEGATES APPROVAL DATE	


PLEASE NOTE:

Services locations and dimensions are indicative only and may be subject to change.

These plans do not detail the exact location of services. Mirvac does not provide any warranty as to the accuracy or completeness of the information and some constructed services may not be shown. Therefore it is vital that all services are located on site by a suitably qualified person.

Mirvac will not be responsible for any loss, damage or costs incurred as a result of any errors or omissions in relation to the material in this document or for any possible actions ensuing from information contained in the document.

CERTIFICATION OF AS-CONSTRUCTED WORKS BY CIVIL CONTRACTOR	
AS THE PRINCIPAL CONTRACTOR FOR THE ABOVE CIVIL WORKS,PENSAR CONSTRUCTIONS GROUP DO CERTIFY THAT ALL CIVIL WORKS FOR THE DEVELOPMENT AT 26 DARLEN STREEST, BRIDGEMAN DOWNS HAVE BEEN CONSTRUCTED UNDER THE SUPERVISION OF A PENSAR CONSTRUCTIONS GROUP REPRESENTATIVE IN ACCORDANCE WITH THE RELEVANT AUTHORITY STANDARDS, THE APPROVED CIVIL ENGINEERING PLANS AND SPECIFICATION, AND ANY ASSOCIATED APPROVED PLAN AMENDMENTS. WE CONFIRM THAT THE AS CONSTRUCTED DATA AND TESTING CERTIFICATES PROVIDED TO INTELARA INTEGRATED SOLUTIONS REPRESENT A TRUE AND ACCURATE REFLECTION OF THE WORKS COMPLETED ON SITE.	
SIGNATURE :	
NAME :	NICHOLAS SOMERVILLE
DULY AUTHORISED ON BEHALF OF :	PENSAR CONSTRUCTIONS GROUP
DATE :	25/11/15

CERTIFICATION OF AS-CONSTRUCTED WORKS BY SURVEYOR	
QUEENSLAND SURVEYING SOLUTIONS PTY LTD DO CERTIFY THAT THE AS CONSTRUCTED DATA AND PLANS PROVIDED TO PENSAR CONSTRUCTIONS GROUP (AS THE PRINCIPAL CIVIL CONTRACTOR) FOR THE DEVELOPMENT AT 26 DARLEN STREEST, BRIDGEMAN DOWNS IS A TRUE AND ACCURATE REFLECTION OF THE WORKS COMPLETED ON SITE. WE CONFIRM THAT ALL DATA AND PLANS HAVE BEEN PRESENTED USING THE CORRECT DATUM AND ORIENTATION APPROPRIATE TO THE SITE IN A FORMAT AS REQUIRED BY THE RELEVANT LOCAL AUTHORITY STANDARDS.	
SIGNATURE :	
NAME :	JOHN DONALD O'BRIEN
DULY AUTHORISED ON BEHALF OF :	QUEENSLAND SURVEYING SOLUTIONS PTY LTD
DATE :	24/11/15

AHD DATUM

BRISBANE CITY COUNCIL			
AS CONSTRUCTED CONTOUR SUBURB : BRIDGEMAN DOWNS FACET NO.			
SURVEY	QUEENSLAND SURVEYING SOLUTIONS PTY LTD	SCALE 1:500 (A3)	NO. 4 of 4 SHEET
CHECKED		DRAWING NO.	QSS519 - 000 - A